
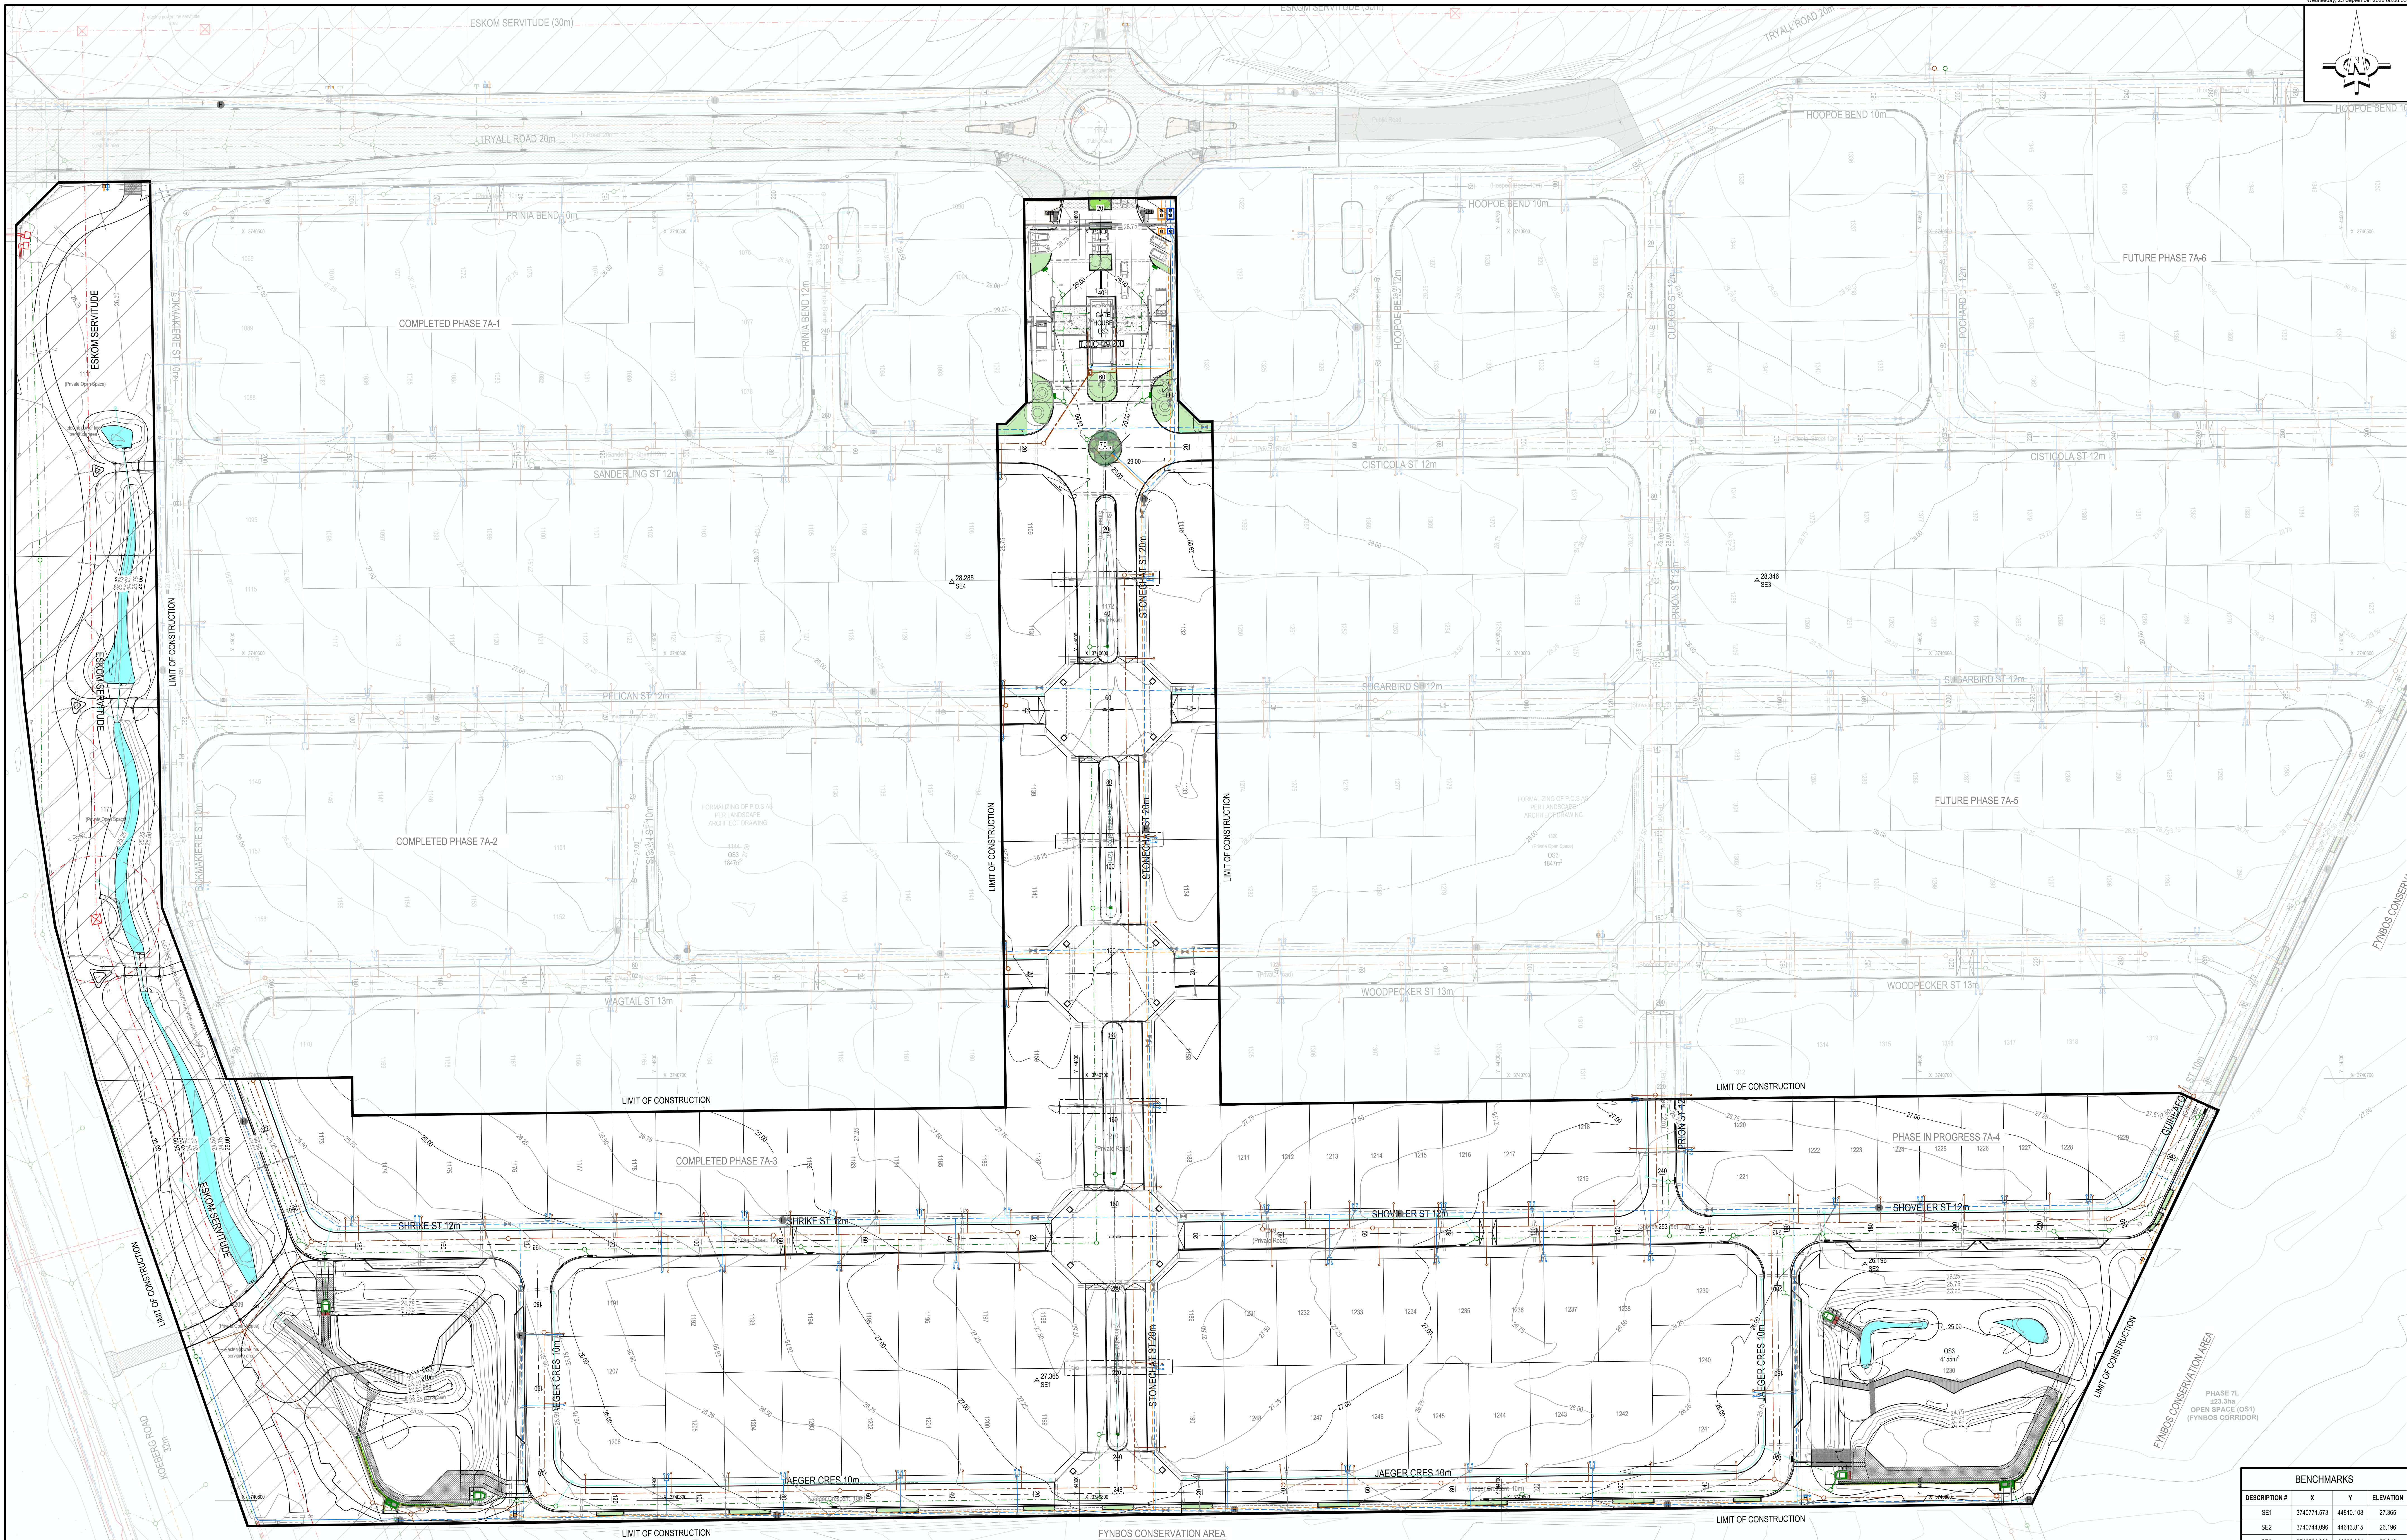


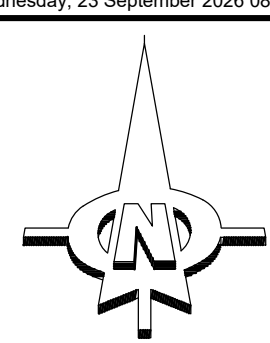

EXISTING SEWER LINE	EXISTING WATER MAIN
NEW SEWER LINE	NEW WATER MAIN
EXISTING SEWER MANHOLE	EXISTING FIRE MAIN
NEW SEWER MANHOLE	NEW FIRE MAIN
EXISTING TREATED EFFLUENT LINE	EXISTING TREATED EFFLUENT MAIN
NEW TREATED EFFLUENT LINE	NEW TREATED EFFLUENT MAIN
EXISTING STORMWATER MANHOLE	EXISTING STORMWATER MANHOLE
NEW STORMWATER MANHOLE	NEW STORMWATER MANHOLE
EXISTING STORMWATER CATCHMENT	NEW STORMWATER CATCHMENT
NEW STORMWATER CATCHMENT	NEW STORMWATER CATCHMENT
EXISTING SUBSOIL LINE	NEW SUBSOIL LINE
NEW SUBSOIL LINE	NEW SUBSOIL LINE

EXISTING NON RETURN VALVE	NEW NON RETURN VALVE
75mm CORE SLEEVE INSIDE 110mm SLEEVE	NEW 75mm CORE SLEEVE INSIDE 110mm SLEEVE
200mm CORE SLEEVE INSIDE 110mm SLEEVE	NEW 200mm CORE SLEEVE INSIDE 110mm SLEEVE
EXISTING TELECOMMUNICATION LINE	NEW TELECOMMUNICATION LINE
EXISTING TELECOMMUNICATION MANHOLE	NEW TELECOMMUNICATION MANHOLE
EXISTING TELECOMMUNICATION DUCT	NEW TELECOMMUNICATION DUCT
EXISTING TELECOMMUNICATION DUCT FOR FUTURE USE	NEW TELECOMMUNICATION DUCT FOR FUTURE USE
50mm WATER HOUSE CONNECTION	NEW 50mm WATER HOUSE CONNECTION
150mm WATER HOUSE CONNECTION	NEW 150mm WATER HOUSE CONNECTION
SEWER HOUSE CONNECTION	NEW SEWER HOUSE CONNECTION
TREATED EFFLUENT HOUSE CONNECTION	NEW TREATED EFFLUENT HOUSE CONNECTION

NEW SUBSOIL MANHOLE	NEW SUBSOIL ROOFING EYE
EXISTING SUBSOIL MANHOLE	EXISTING SUBSOIL ROOFING EYE
EXISTING SUBSOIL ROOFING EYE	EXISTING SUBSOIL ROOFING EYE
EXISTING SUBSOIL ROOFING EYE	EXISTING SUBSOIL ROOFING EYE
APPROVED BY COUNCIL / CLIENT	DATE	INITIAL	IN CODE	REVISION DESCRIPTION	CLIENT
CITY ENGINEER / CLIENT	15/12/2020	JAS	210	ASBUILT DRAWING	
RES. NO.	DATE			REVISED ASBUILT DRAWING	
15/12/2020	16/09/2026	JAS	210		

AMENDMENTS CODE	DATE	INITIAL	IN CODE	REVISION DESCRIPTION	CLIENT
A.S.C. (1) BEFORE TENDER					
B. (1) TENDER DRAWING					
C. (1) CHECKED ELECTRICAL					
D. (1) B.I.					
E. (1) OTHER					

MILNERTON ESTATES
PROPERTY DEVELOPERS

bvi 50
CELEBRATION
EST 1967-2017

PROJECT	OFFICE	EMAIL
Planning	Planning	planning@bvi.co.za
Finance	Finance	finance@bvi.co.za
Marketing	Marketing	marketing@bvi.co.za
Operations	Operations	operations@bvi.co.za
Human Resources	Human Resources	hr@bvi.co.za
Information Technology	Information Technology	it@bvi.co.za
Legal	Legal	legal@bvi.co.za
Health & Safety	Health & Safety	hse@bvi.co.za
Construction	Construction	construction@bvi.co.za
Facilities Management	Facilities Management	fm@bvi.co.za
Energy	Energy	energy@bvi.co.za
Water	Water	water@bvi.co.za

THE CONSTRUCTION OF ROADS AND CIVIL SERVICES FOR SANDALWOOD PHASE 1

DESCRIPTION #	X	Y	ELEVATION
SE1	3740771.573	44910.108	27.365
SE2	3740744.096	44913.815	26.196
SE3	3740581.906	44939.364	26.346
SE4	3740592.279	44930.287	26.295